

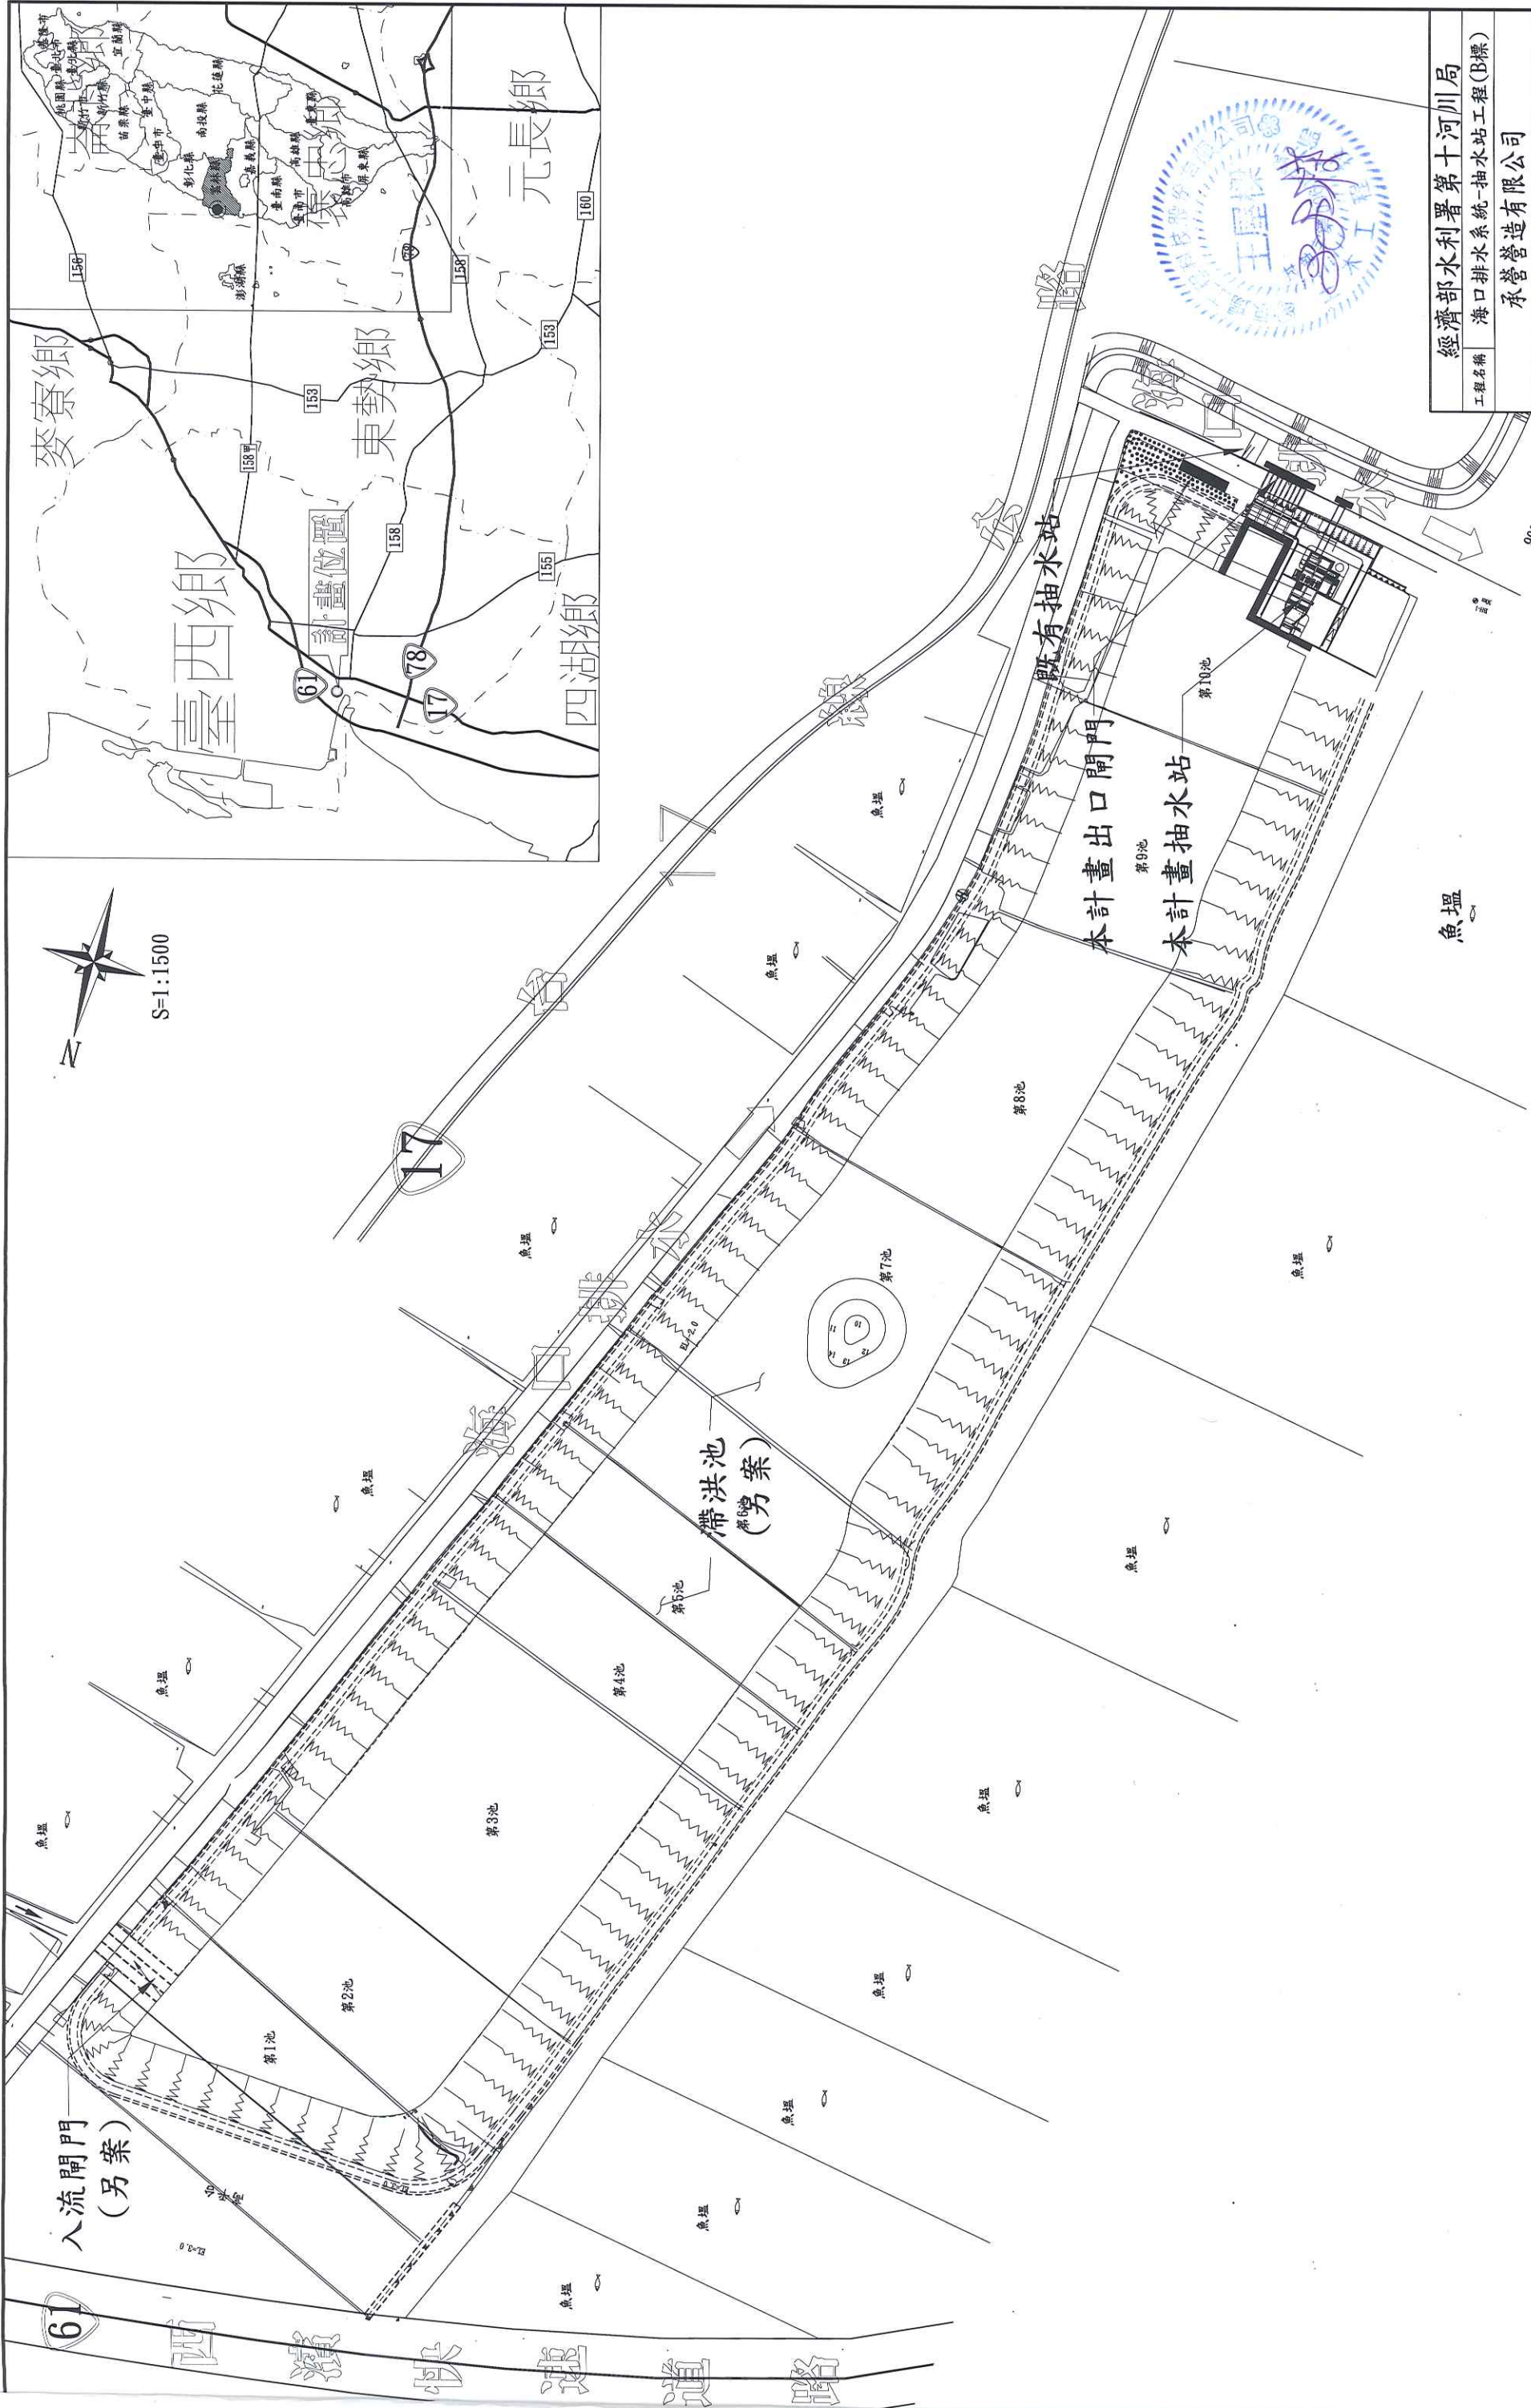


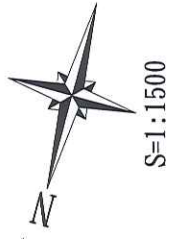

經濟部水利署第十河川局	
工程名稱	海口排水系統-抽水站工程(B標)
承營造有限公司	
竣工圖	
圖名	工程位置圖
繪圖	365516
設計	365516
校核	365516
日期	101.02.17
審核	365516
批准	365516
技師簽證	365516
圖號	G-02

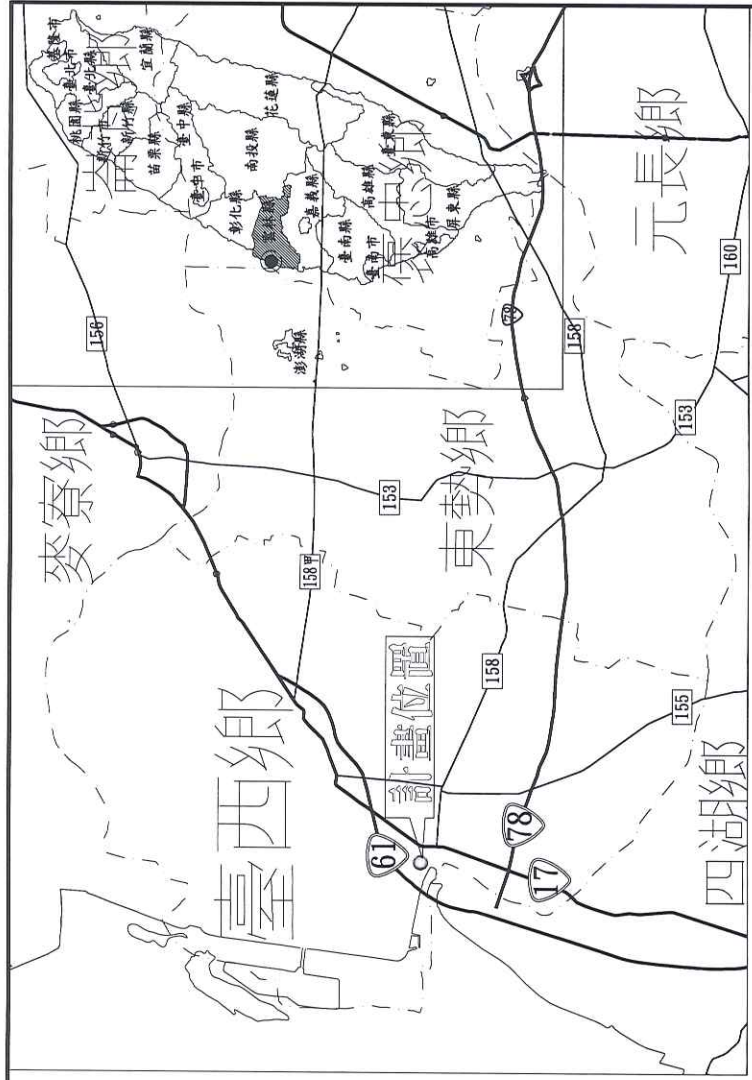